

# CITY OF TAMARAC

## PUBLIC WORKS DEPARTMENT ENGINEERING DIVISION


### DRAINAGE IMPROVEMENTS THE BOULEVARDS

INDEX OF TRAFFIC CALMING PLANS

DESCRIPTION	SHEET No.
COVER SHEET	1
SITE PLAN	2
SITE PLAN	3

START OF  
PROJECT

THE PUBLIC ROADWAY(S) INDICATED ON THESE PLANS HAVE BEEN DESIGNED IN ACCORDANCE WITH THE "MANUAL OF UNIFORM MINIMUM STANDARDS FOR DESIGN, CONSTRUCTION AND MAINTENANCE FOR STREETS & HIGHWAYS - STATE OF FLORIDA".

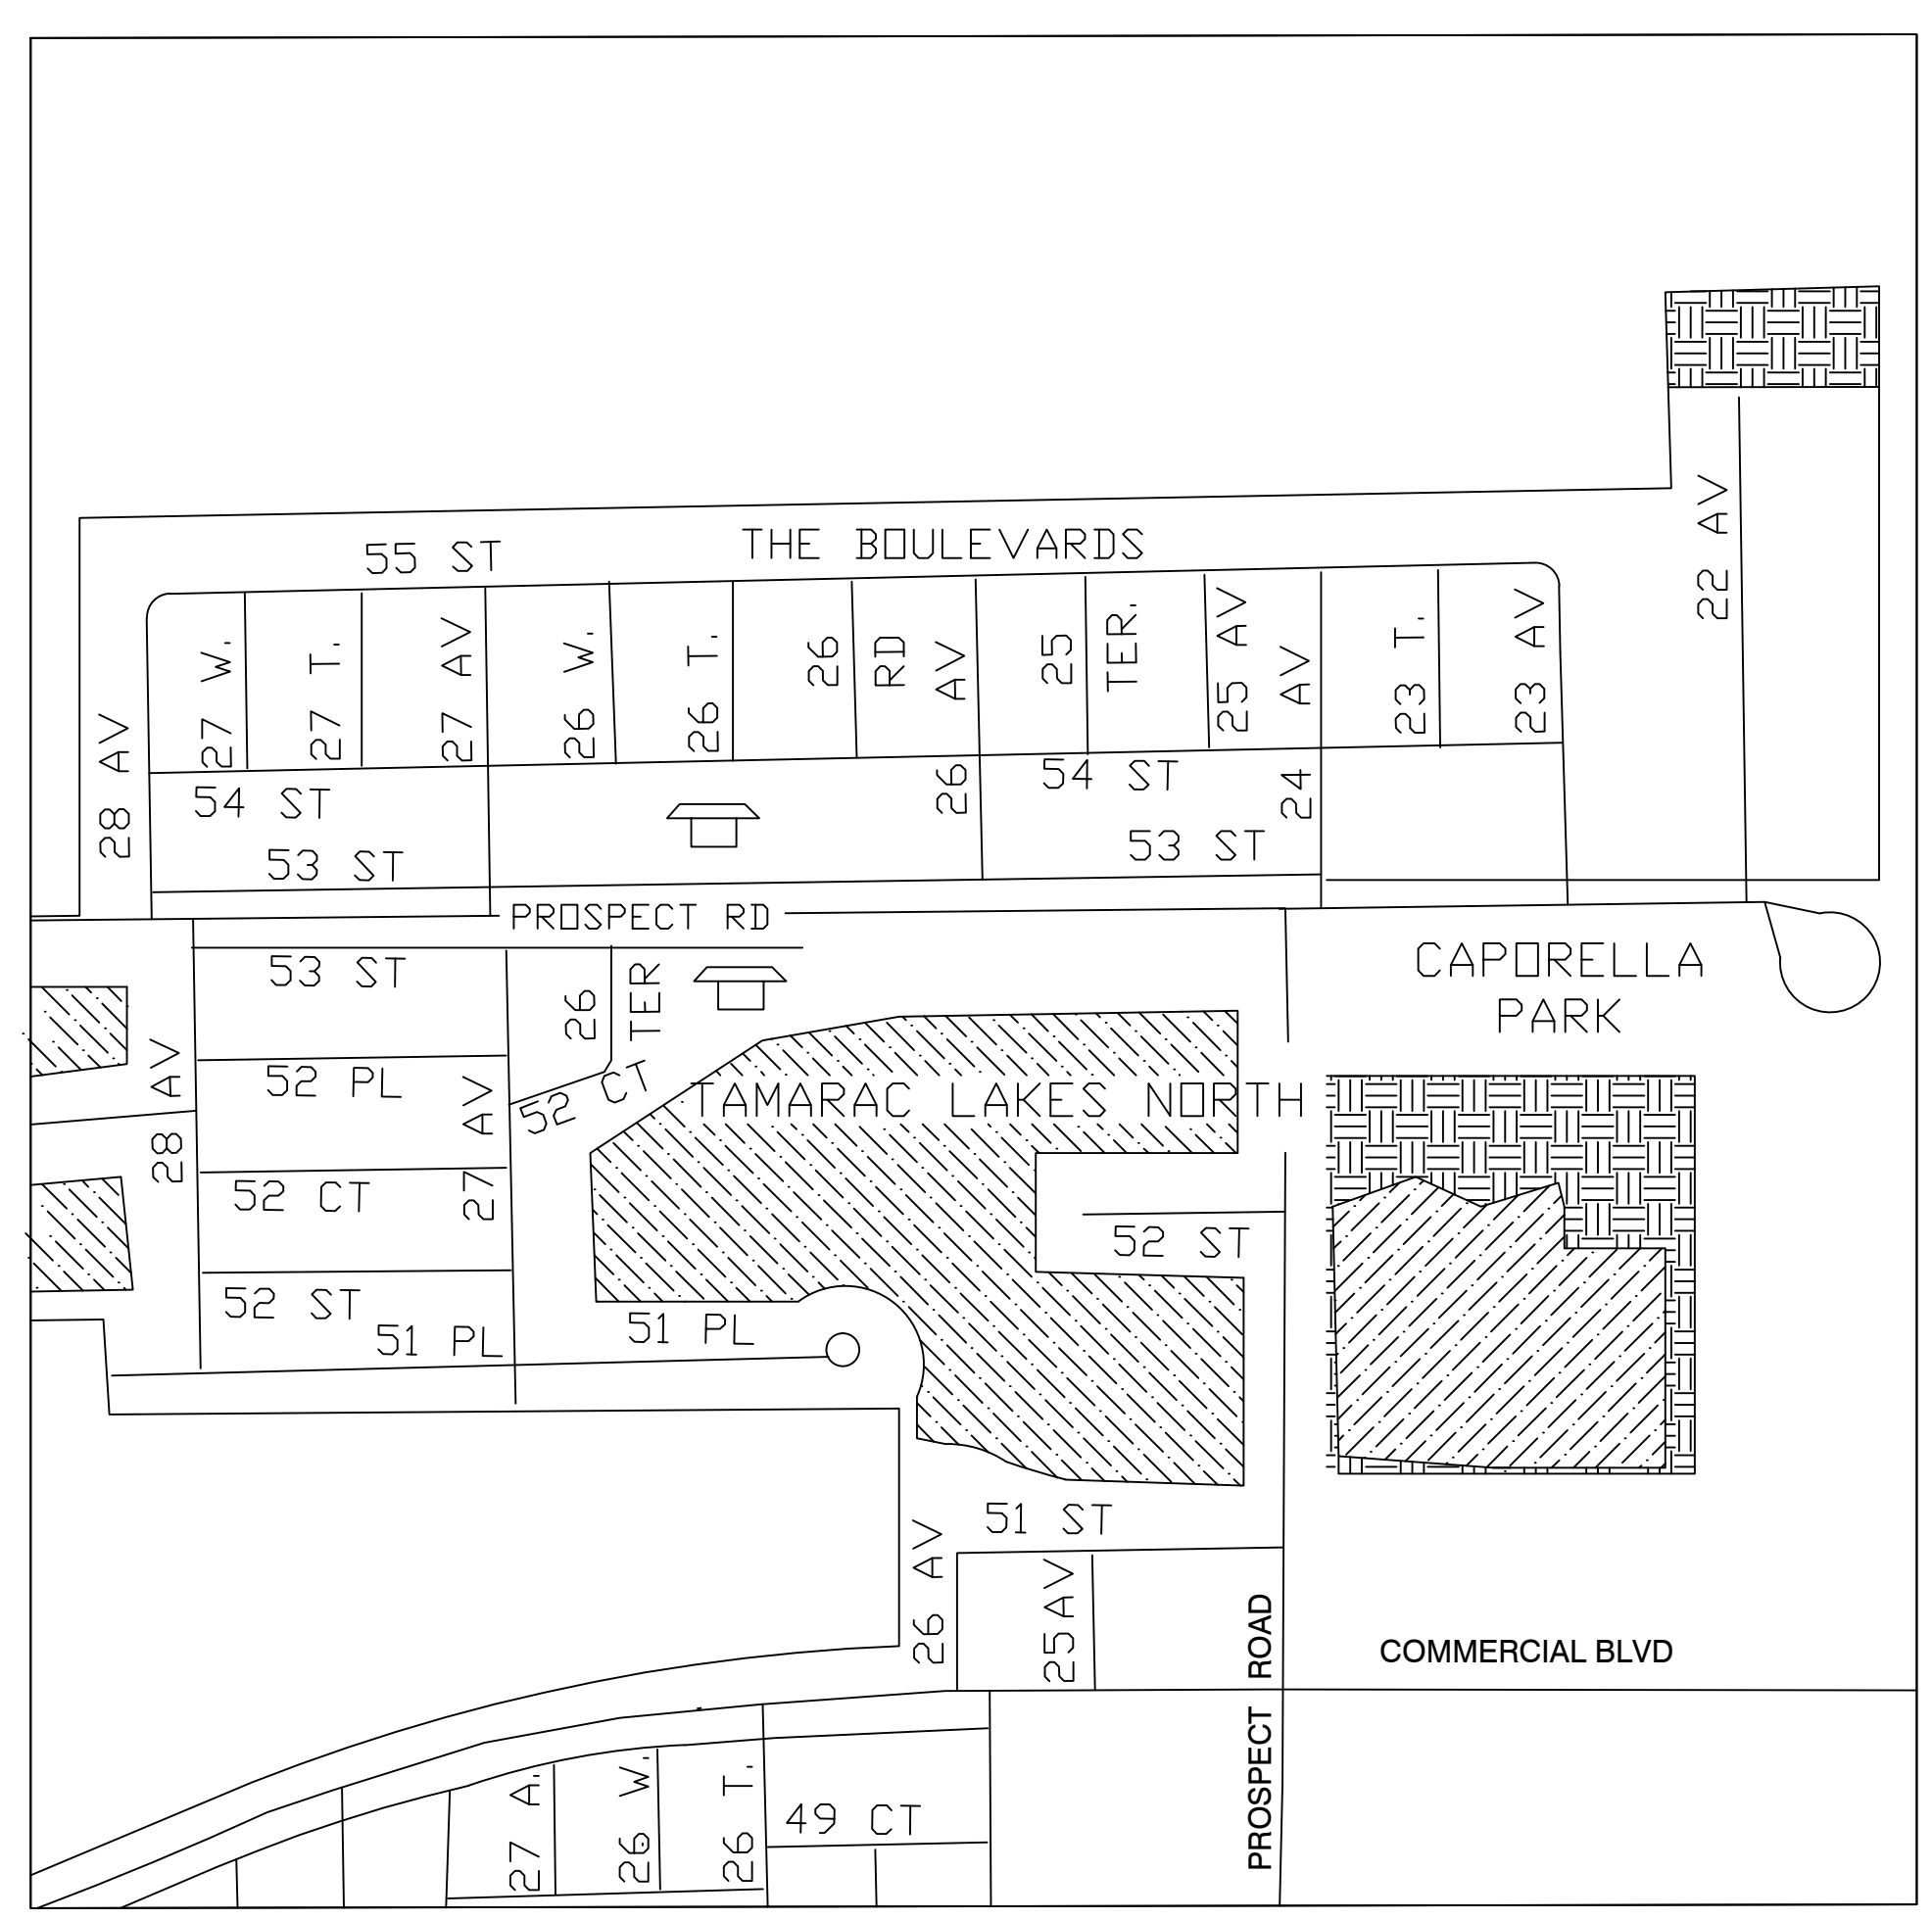

END OF  
PROJECT

LOCATION MAP

**CITY COMMISSION:**

Harry Dressler	Mayor
Diane Glasser	Vice Mayor
Michele J Gomez	Commissioner
Debra Placko	Commissioner
Pamela Bushnell	Commissioner

**PREPARED BY:**



City of Tamarac  
Public Works Department  
Engineering Division  
6011 Nob Hill Road  
Tamarac, FL 33321  
Date: October , 2014

RECORD DRAWING

FILIPPELLI SURVEYING INC. LB 7822  
RAFAEL FILIPPELLI P.L.S.#4901  
17831 ORANGE GROVE BLVD.  
LOXAHATCHEE FL, 33470  
CELL:(561)719-0025  
FAX:(888)668-9553

12-17-18

Seal:	Scale: NTS
	COVER SHEET
JOHN E. DOHERTY, P.E. FL. NO. 55383	SHEET 1 OF 3

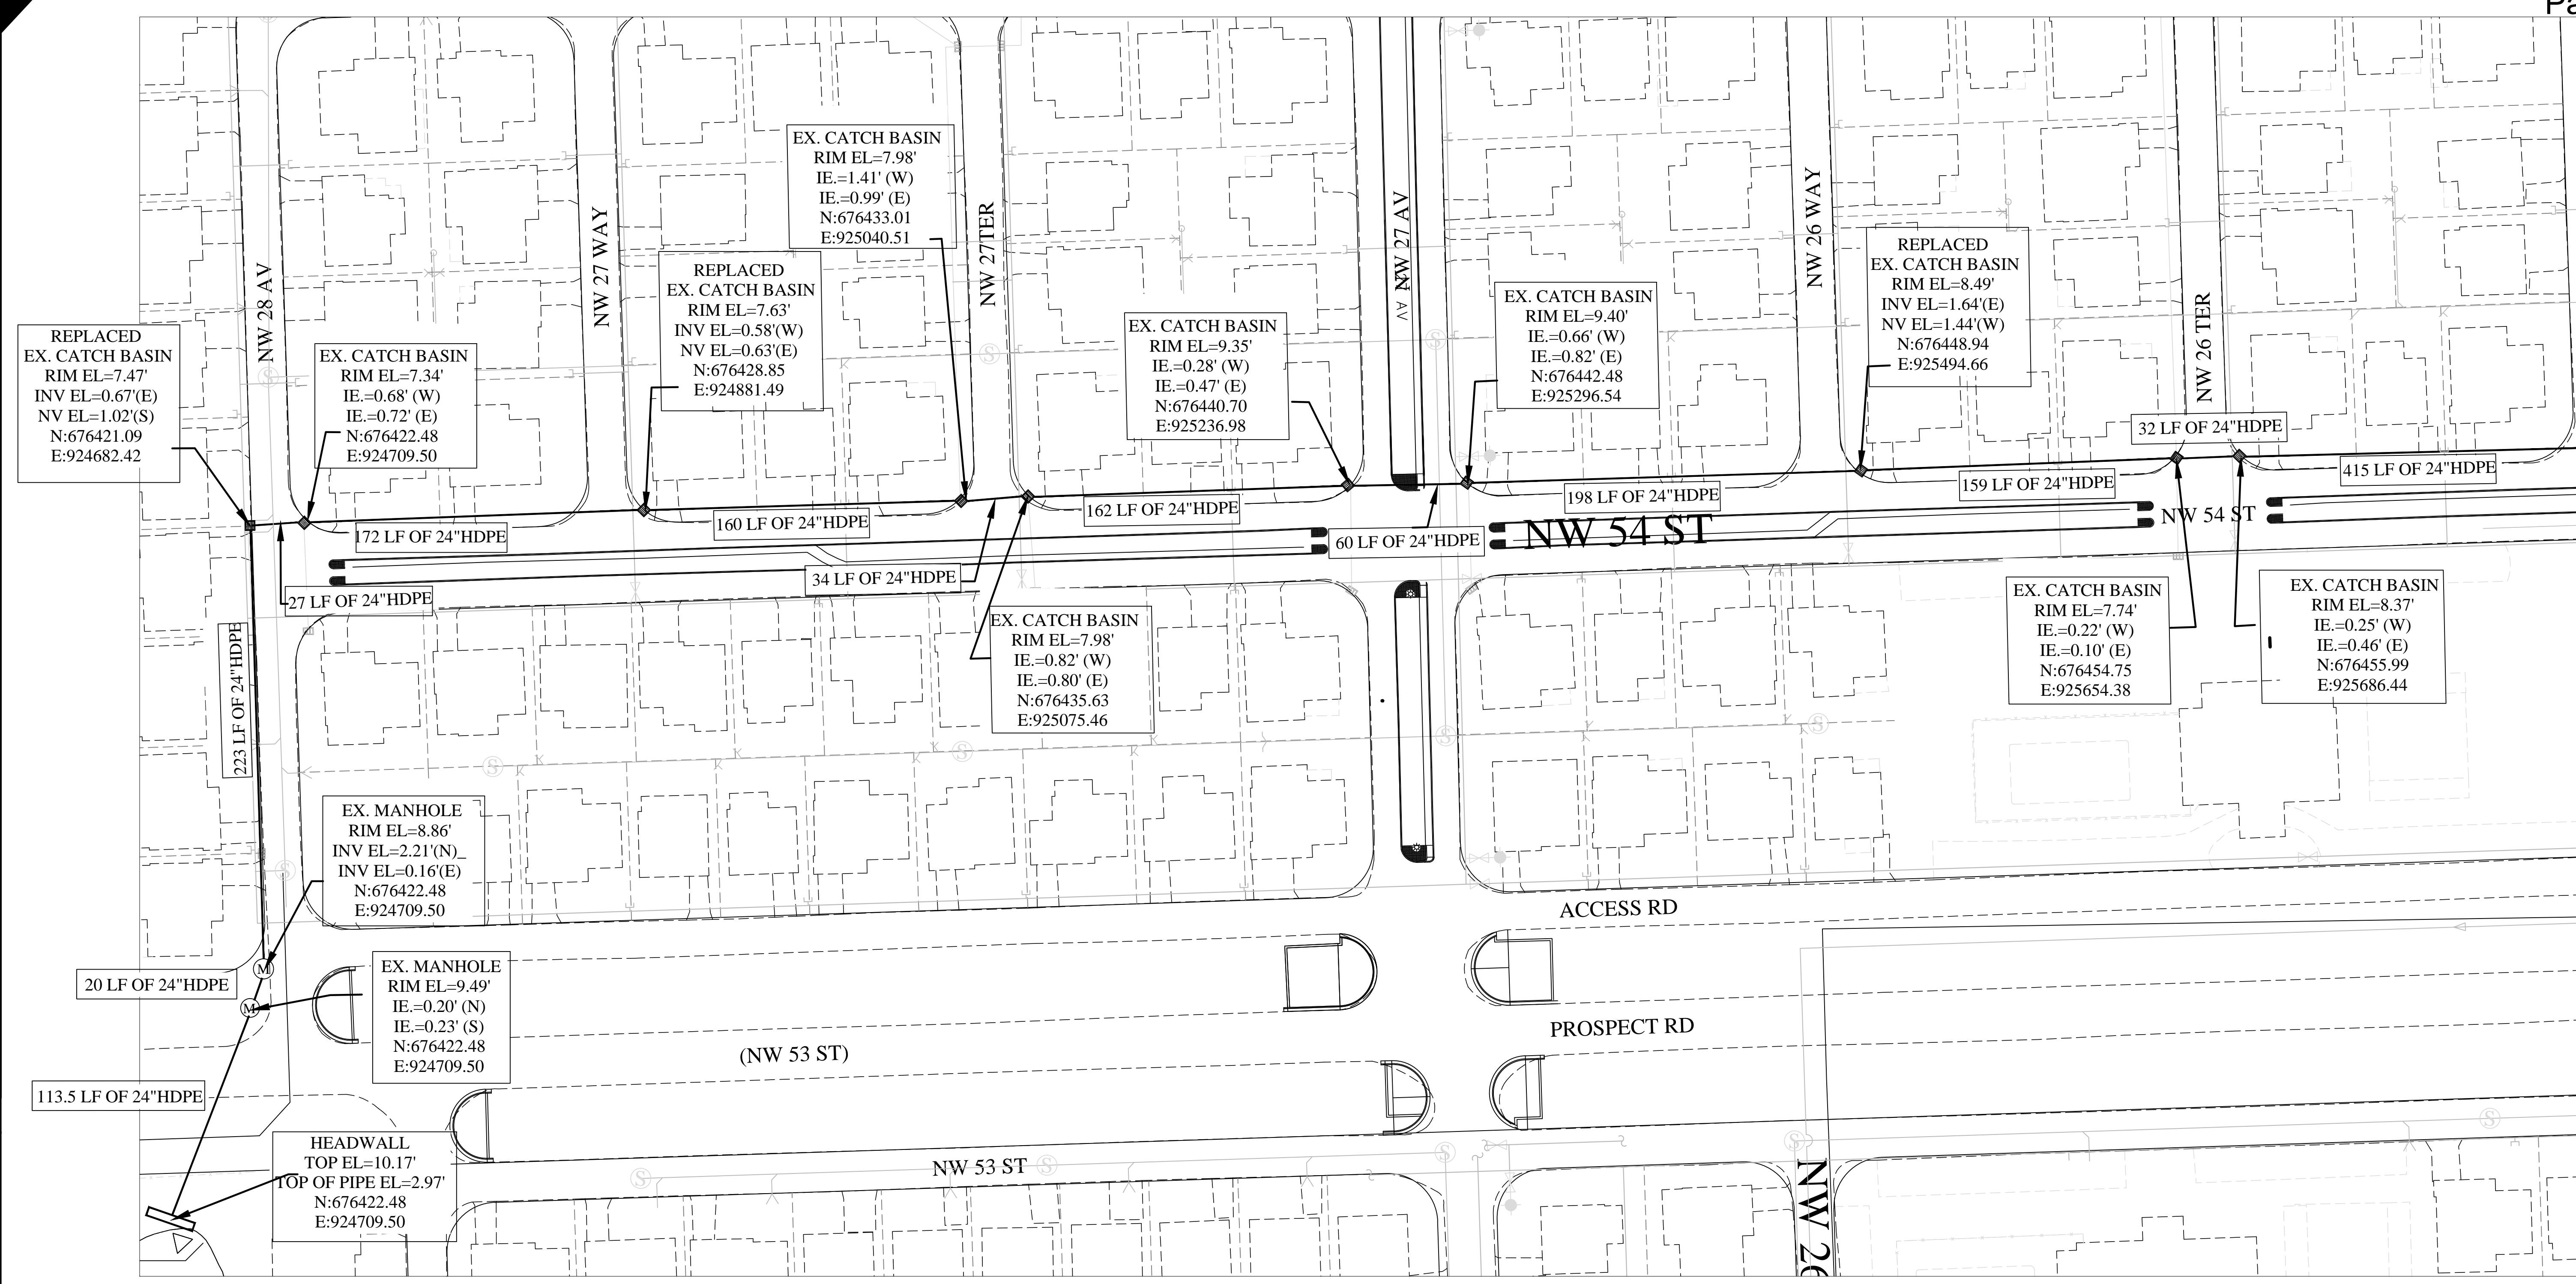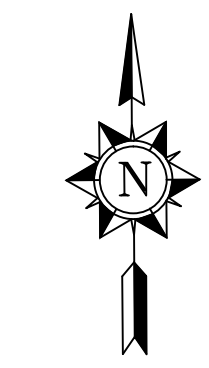

MATCHLINE SEE PG 3 OF 3

FILIPPELLI SURVEYING INC. LB 7822  
RAFAEL FILIPPELLI P.L.S.#4901  
17831 ORANGE GROVE BLVD.  
LOXAHATCHEE FL, 33470  
CELL:(561)719-0025  
FAX:(888)668-9553

12-17-18

REVISIONS			REVISIONS		
No.	Date	Remarks	No.	Date	Remarks



Design By: \_\_\_\_\_ Date: \_\_\_\_\_  
 Drawn By: \_\_\_\_\_ Date: \_\_\_\_\_  
 Checked By: \_\_\_\_\_ Date: \_\_\_\_\_  
 Approved By: \_\_\_\_\_ Date: \_\_\_\_\_

**CITY OF TAMARAC**  
PUBLIC SERVICES DEPARTMENT  
ENGINEERING DIVISION

Seal: \_\_\_\_\_  
JOHN E. DOHERTY, P.E.  
FL. NO. 55383

**Tamarac Lakes**  
**North Boulevards Sec.**

Job No. \_\_\_\_\_  
Scale: 1" = 40'  
SHEET 2 OF 3

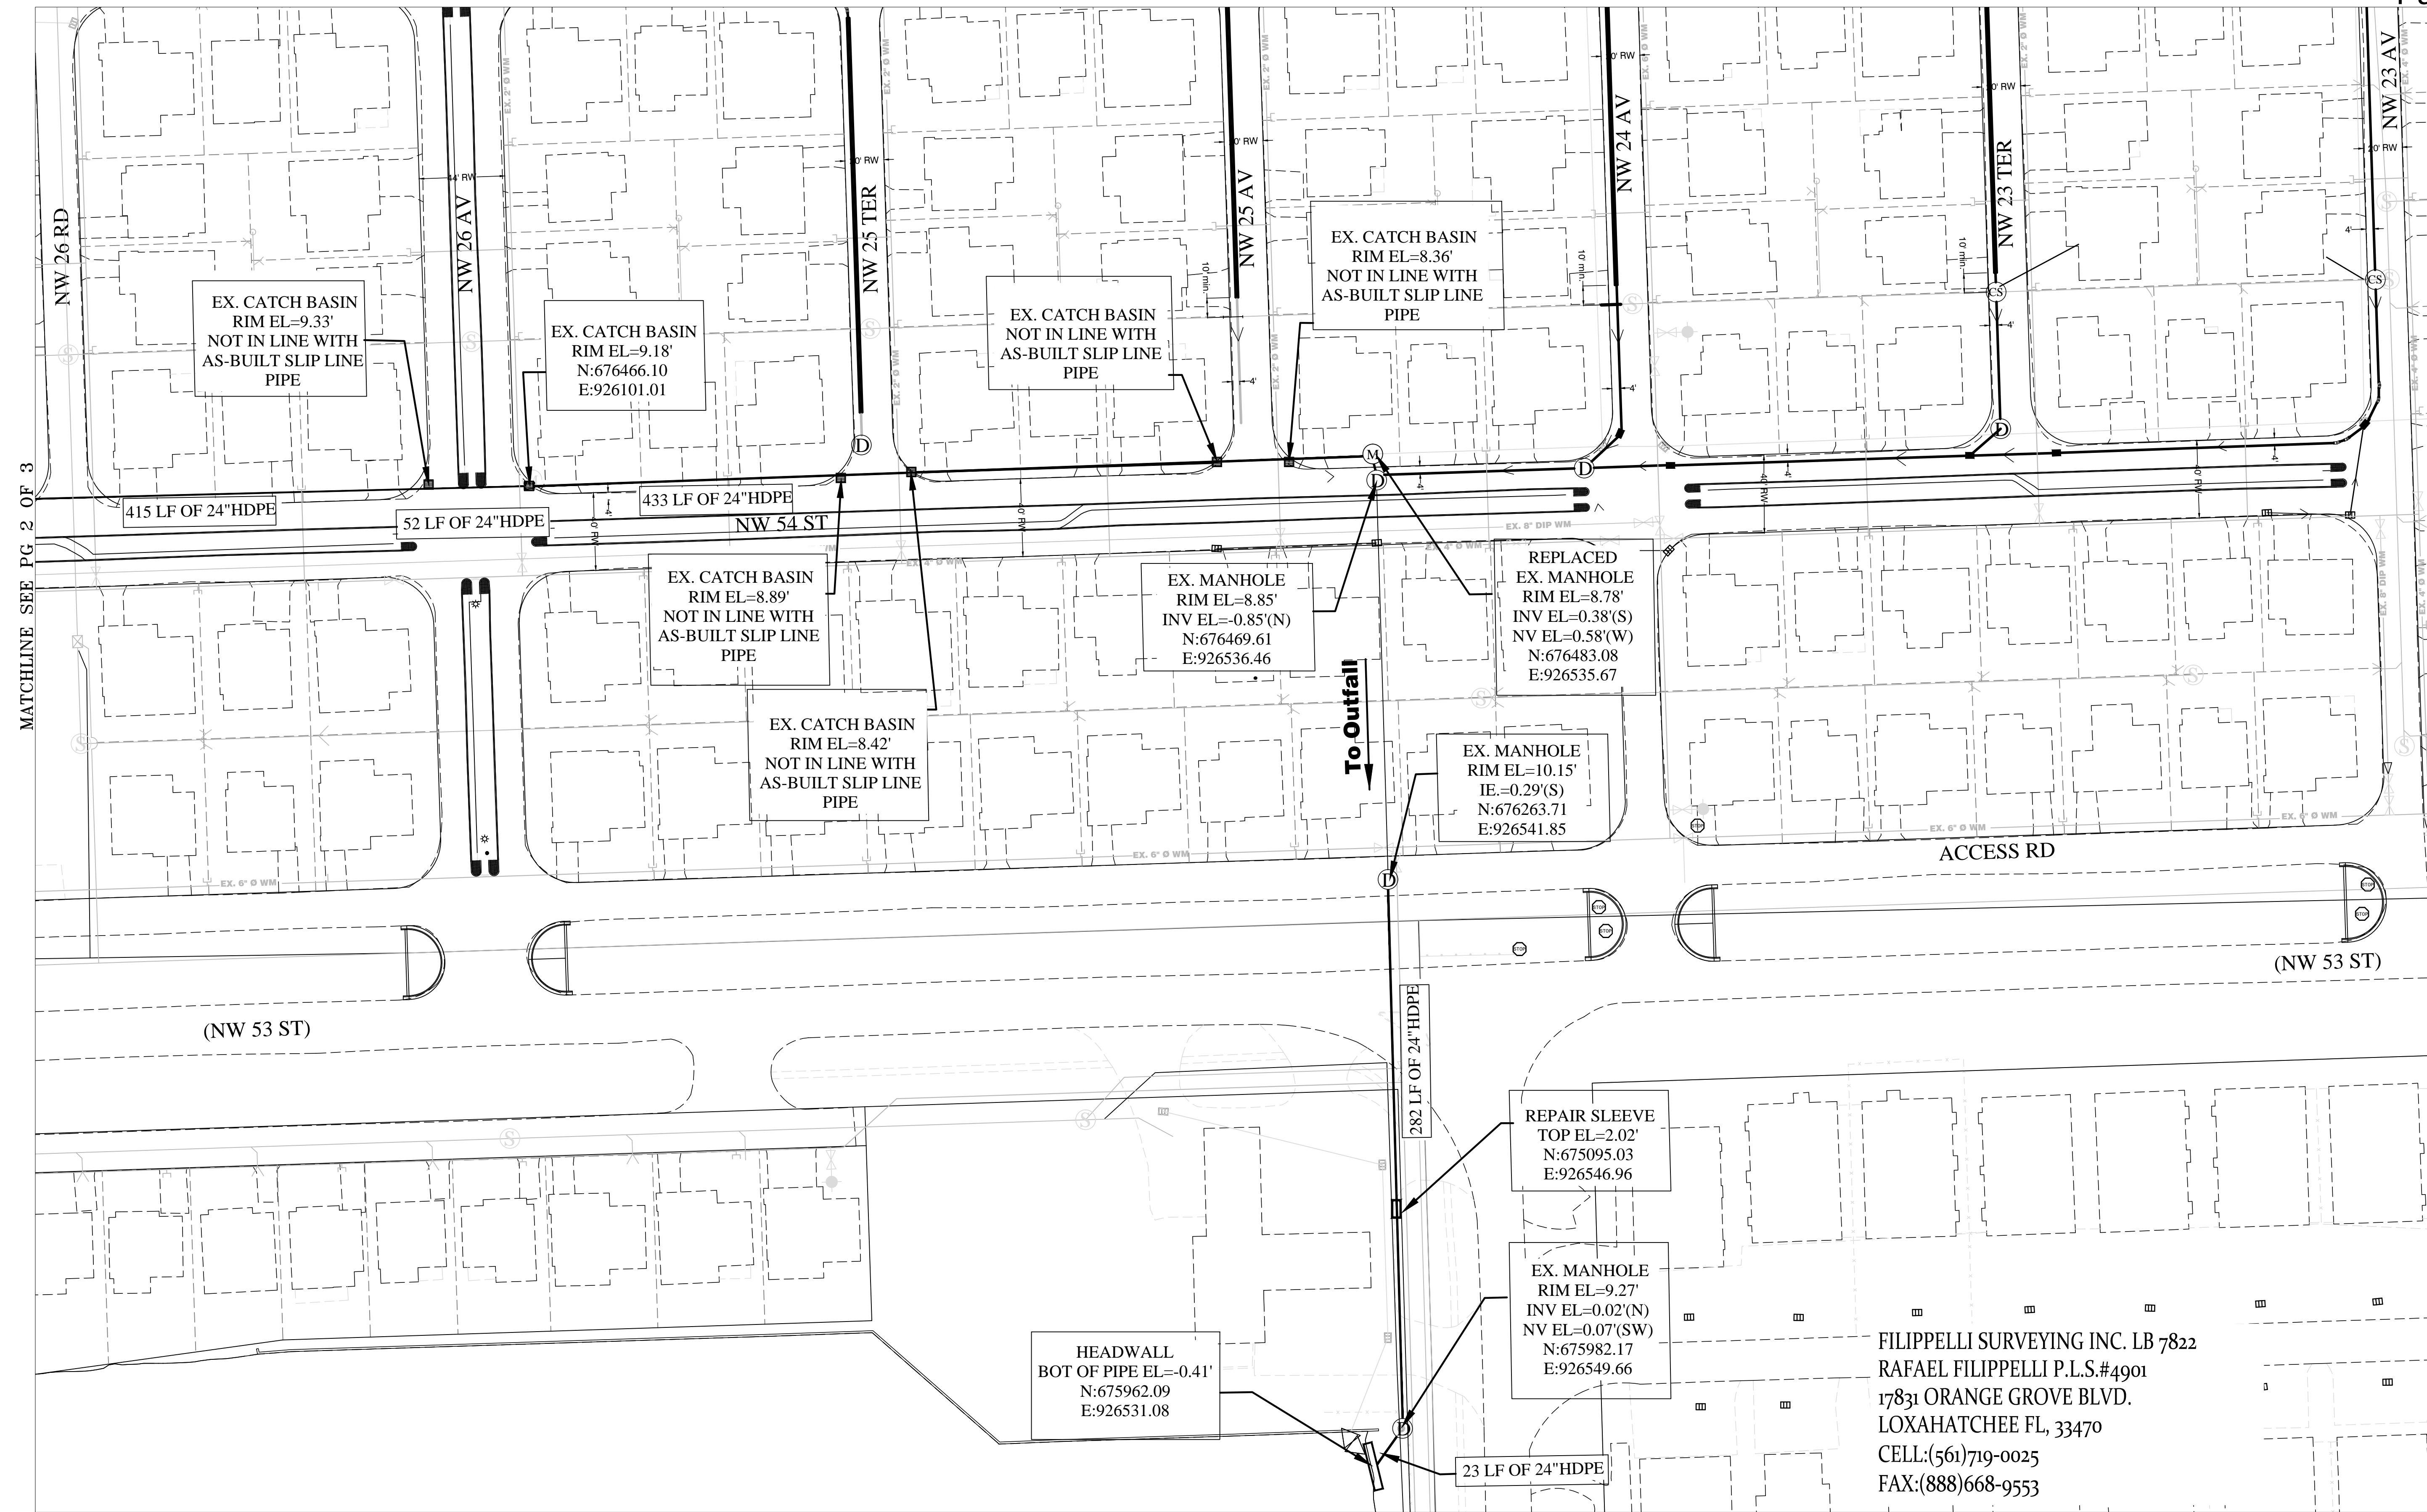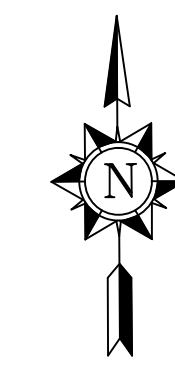

MATCHLINE SEE PG 2 OF 3

FILIPPELLI SURVEYING INC. LB 7822  
 RAFAEL FILIPPELLI P.L.S.#4901  
 17831 ORANGE GROVE BLVD.  
 LOXAHATCHEE FL, 33470  
 CELL:(561)719-0025  
 FAX:(888)668-9553

12-17-18

REVISIONS			REVISIONS		
No.	Date	Remarks	No.	Date	Remarks

Design By: \_\_\_\_\_ Date: \_\_\_\_\_  
 Drawn By: \_\_\_\_\_ Date: \_\_\_\_\_  
 Checked By: \_\_\_\_\_ Date: \_\_\_\_\_  
 Approved By: \_\_\_\_\_ Date: \_\_\_\_\_

**CITY OF TAMARAC**  
 PUBLIC SERVICES DEPARTMENT  
 ENGINEERING DIVISION

Seal:  
 JOHN E. DOHERTY, P.E.  
 FL. NO. 55383

**Tamarac Lakes**  
**North Boulevards Sec.**

Job No. \_\_\_\_\_  
 Scale: 1" = 40'  
**SHEET 3 OF 3**